

SEE FEDERAL HIGHWAY EASEMENT
TO STATE OF NEW HAMPSHIRE FOR
THIS PROJECT RECORDED C 2779/3,
4/15/09 (SCANNED INTO RIGHT-OF-WAY
MANAGEMENT SYSTEM, PROJECT 13632, (NOT "B"))


SEE ALSO THE 2014 KANCAMAGUS
HIGHWAY FEDERAL HIGHWAY EASEMENT
TO THE STATE OF NEW HAMPSHIRE
@ 3185/710 (COPY SCANNED INTO V-DRIVE)
WHICH EXTINGUISHES THE EASEMENT
NOTED ABOVE

STATE OF NEW HAMPSHIRE
DEPARTMENT OF TRANSPORTATION


CONSTRUCTION PLANS FEDERAL AID PROJECT

X-A000(190)
N.H. PROJECT NO. **13632B**
ROUTE 112 (KANCAMAGUS HIGHWAY)

DESIGN DATA	
AVERAGE DAILY TRAFFIC 2003	2100
AVERAGE DAILY TRAFFIC 2023	2600
PERCENT OF TRUCKS	2
DESIGN SPEED	35 mph
LENGTH OF PROJECT	1.2 miles

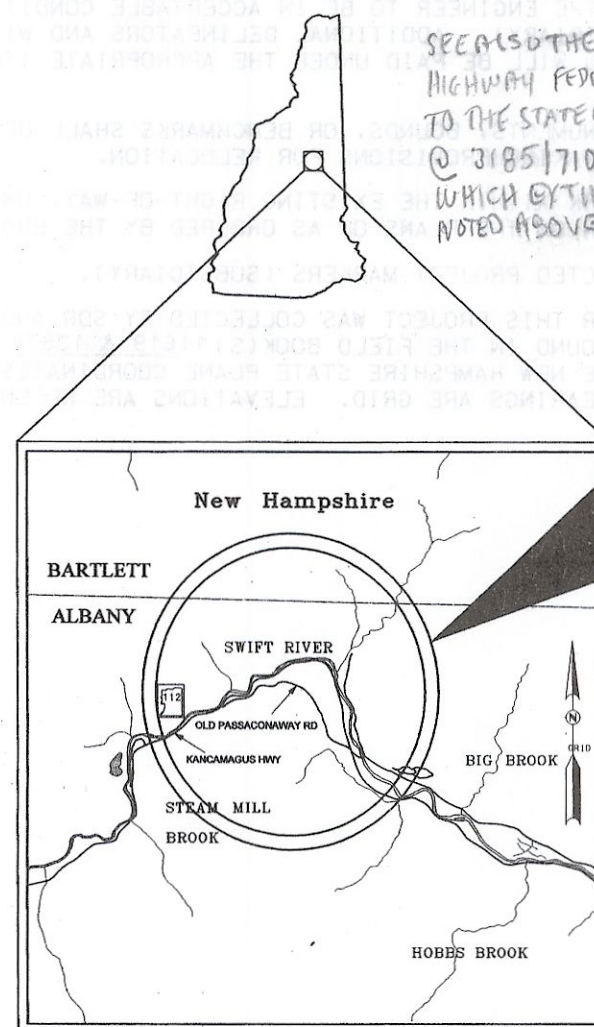

LOCATION MAP

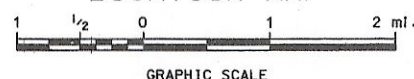

STA. 400+50
LIMIT OF WORK


13632B

PROJECT 13632A STA. 401+00 = **STA. 401+00**
PROJECT 13632B STA. 401+00 **BEGIN PROJECT 13632B**



**STA. 464+00
END CONSTRUCTION**

STA. 464+50
LIMIT OF WORK

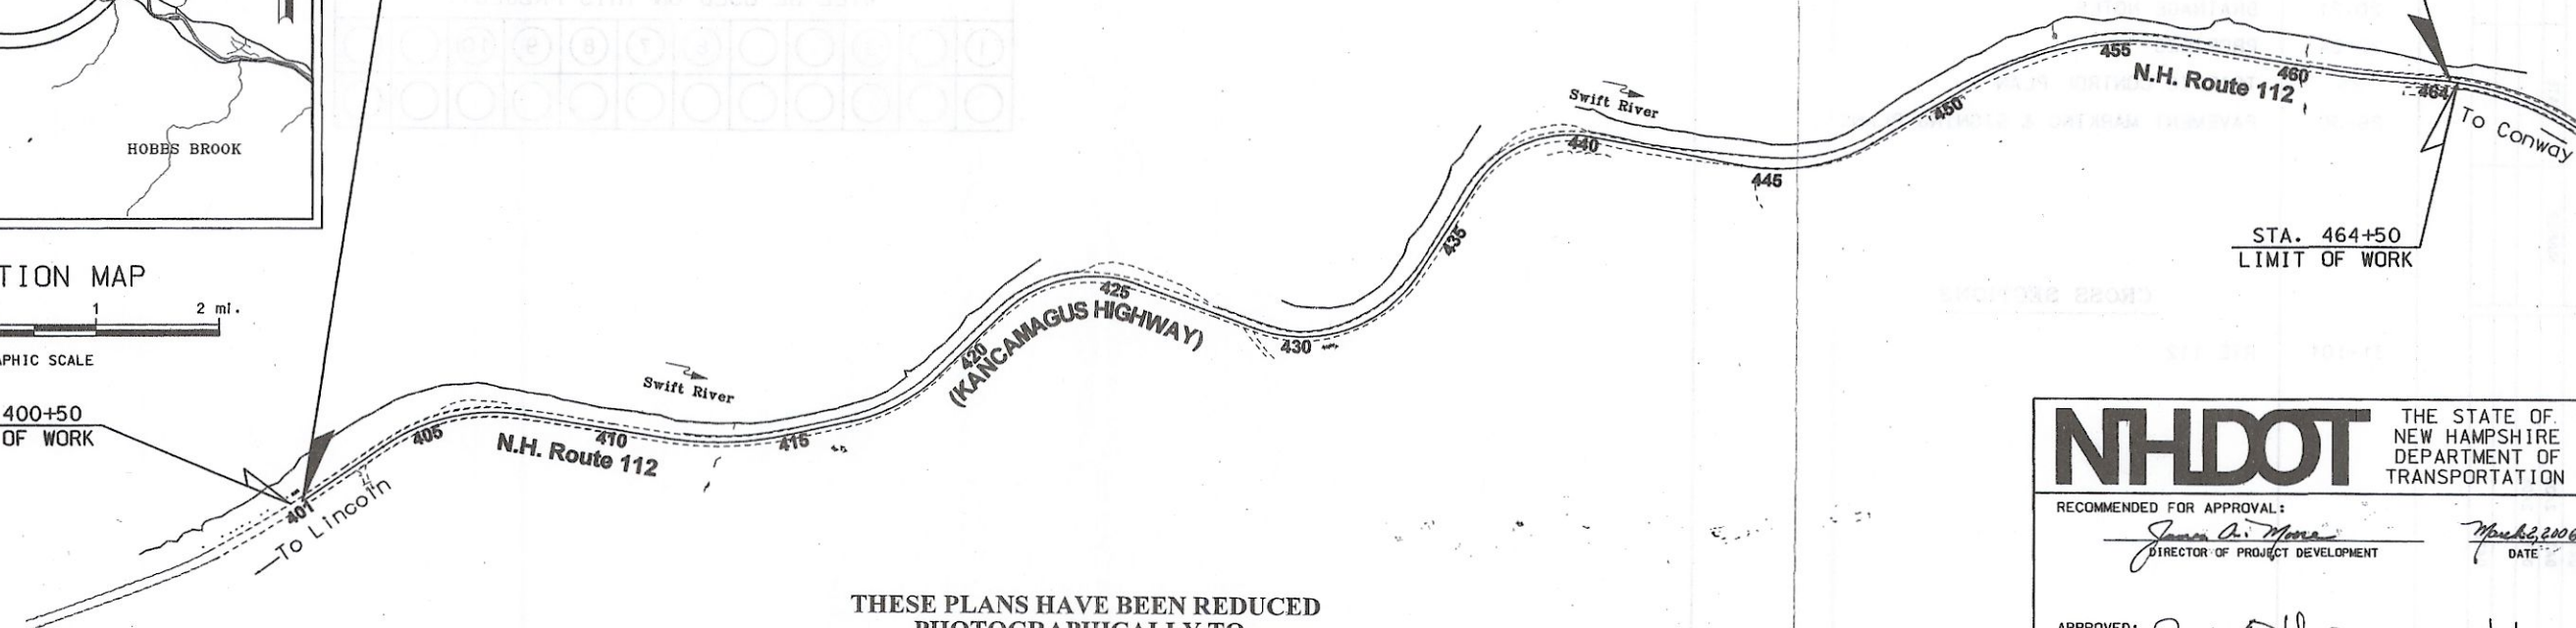

THESE PLANS HAVE BEEN REDUCED
PHOTOGRAPHICALLY TO
APPROXIMATELY 1/2 SCALE

**TOWN OF ALBANY
COUNTY OF CARROLL**

SCALE: 1" = 250'

FOR CONSTRUCTION AND ALIGNMENT DETAILS - SEE CONSTRUCTION PLANS



NHDOT THE STATE OF NEW HAMPSHIRE DEPARTMENT OF TRANSPORTATION			
RECOMMENDED FOR APPROVAL:			
<i>James A. Moore</i> DIRECTOR OF PROJECT DEVELOPMENT		<i>March 2, 2006</i> DATE	
APPROVED: <i>[Signature]</i>		<i>3/2/06</i> DATE	
ASSISTANT COMMISSIONER AND CHIEF ENGINEER			
U. S. DEPARTMENT OF TRANSPORTATION FEDERAL HIGHWAY ADMINISTRATION			
APPROVED: _____		DATE: _____	
DIVISION ADMINISTRATOR			
FEDERAL PROJECT NO. X-A000(190)	STATE PROJECT NO. 13632B	SHEET NO. 1	TOTAL SHEETS 101

DRAWN BY CEB DATE 7/05
CHECKED BY TLR DATE 8/05

U S of America
Tract 14a
27,165.65 Ac +/-


PAR. No.	PROPERTY OWNER	TOTAL AREA OF PARCEL Ac.	TAKE Ac.	REMAINDER		PERMANENT Ac.	EASEMENT		CARROW POINTS OF LT. RT.	REV. No.
				LEFT Ac.	RIGHT Ac.		TYPE	SF.		
TRACT 14a	US OF AMERICA	27,165.65				22.21	R.O.W.			

STA. 410+00

STA. 410+00

LIMIT OF R.O.W.
FOR PROJECT 13632A

LIMIT OF R.O.W.
FOR PROJECT 13632B

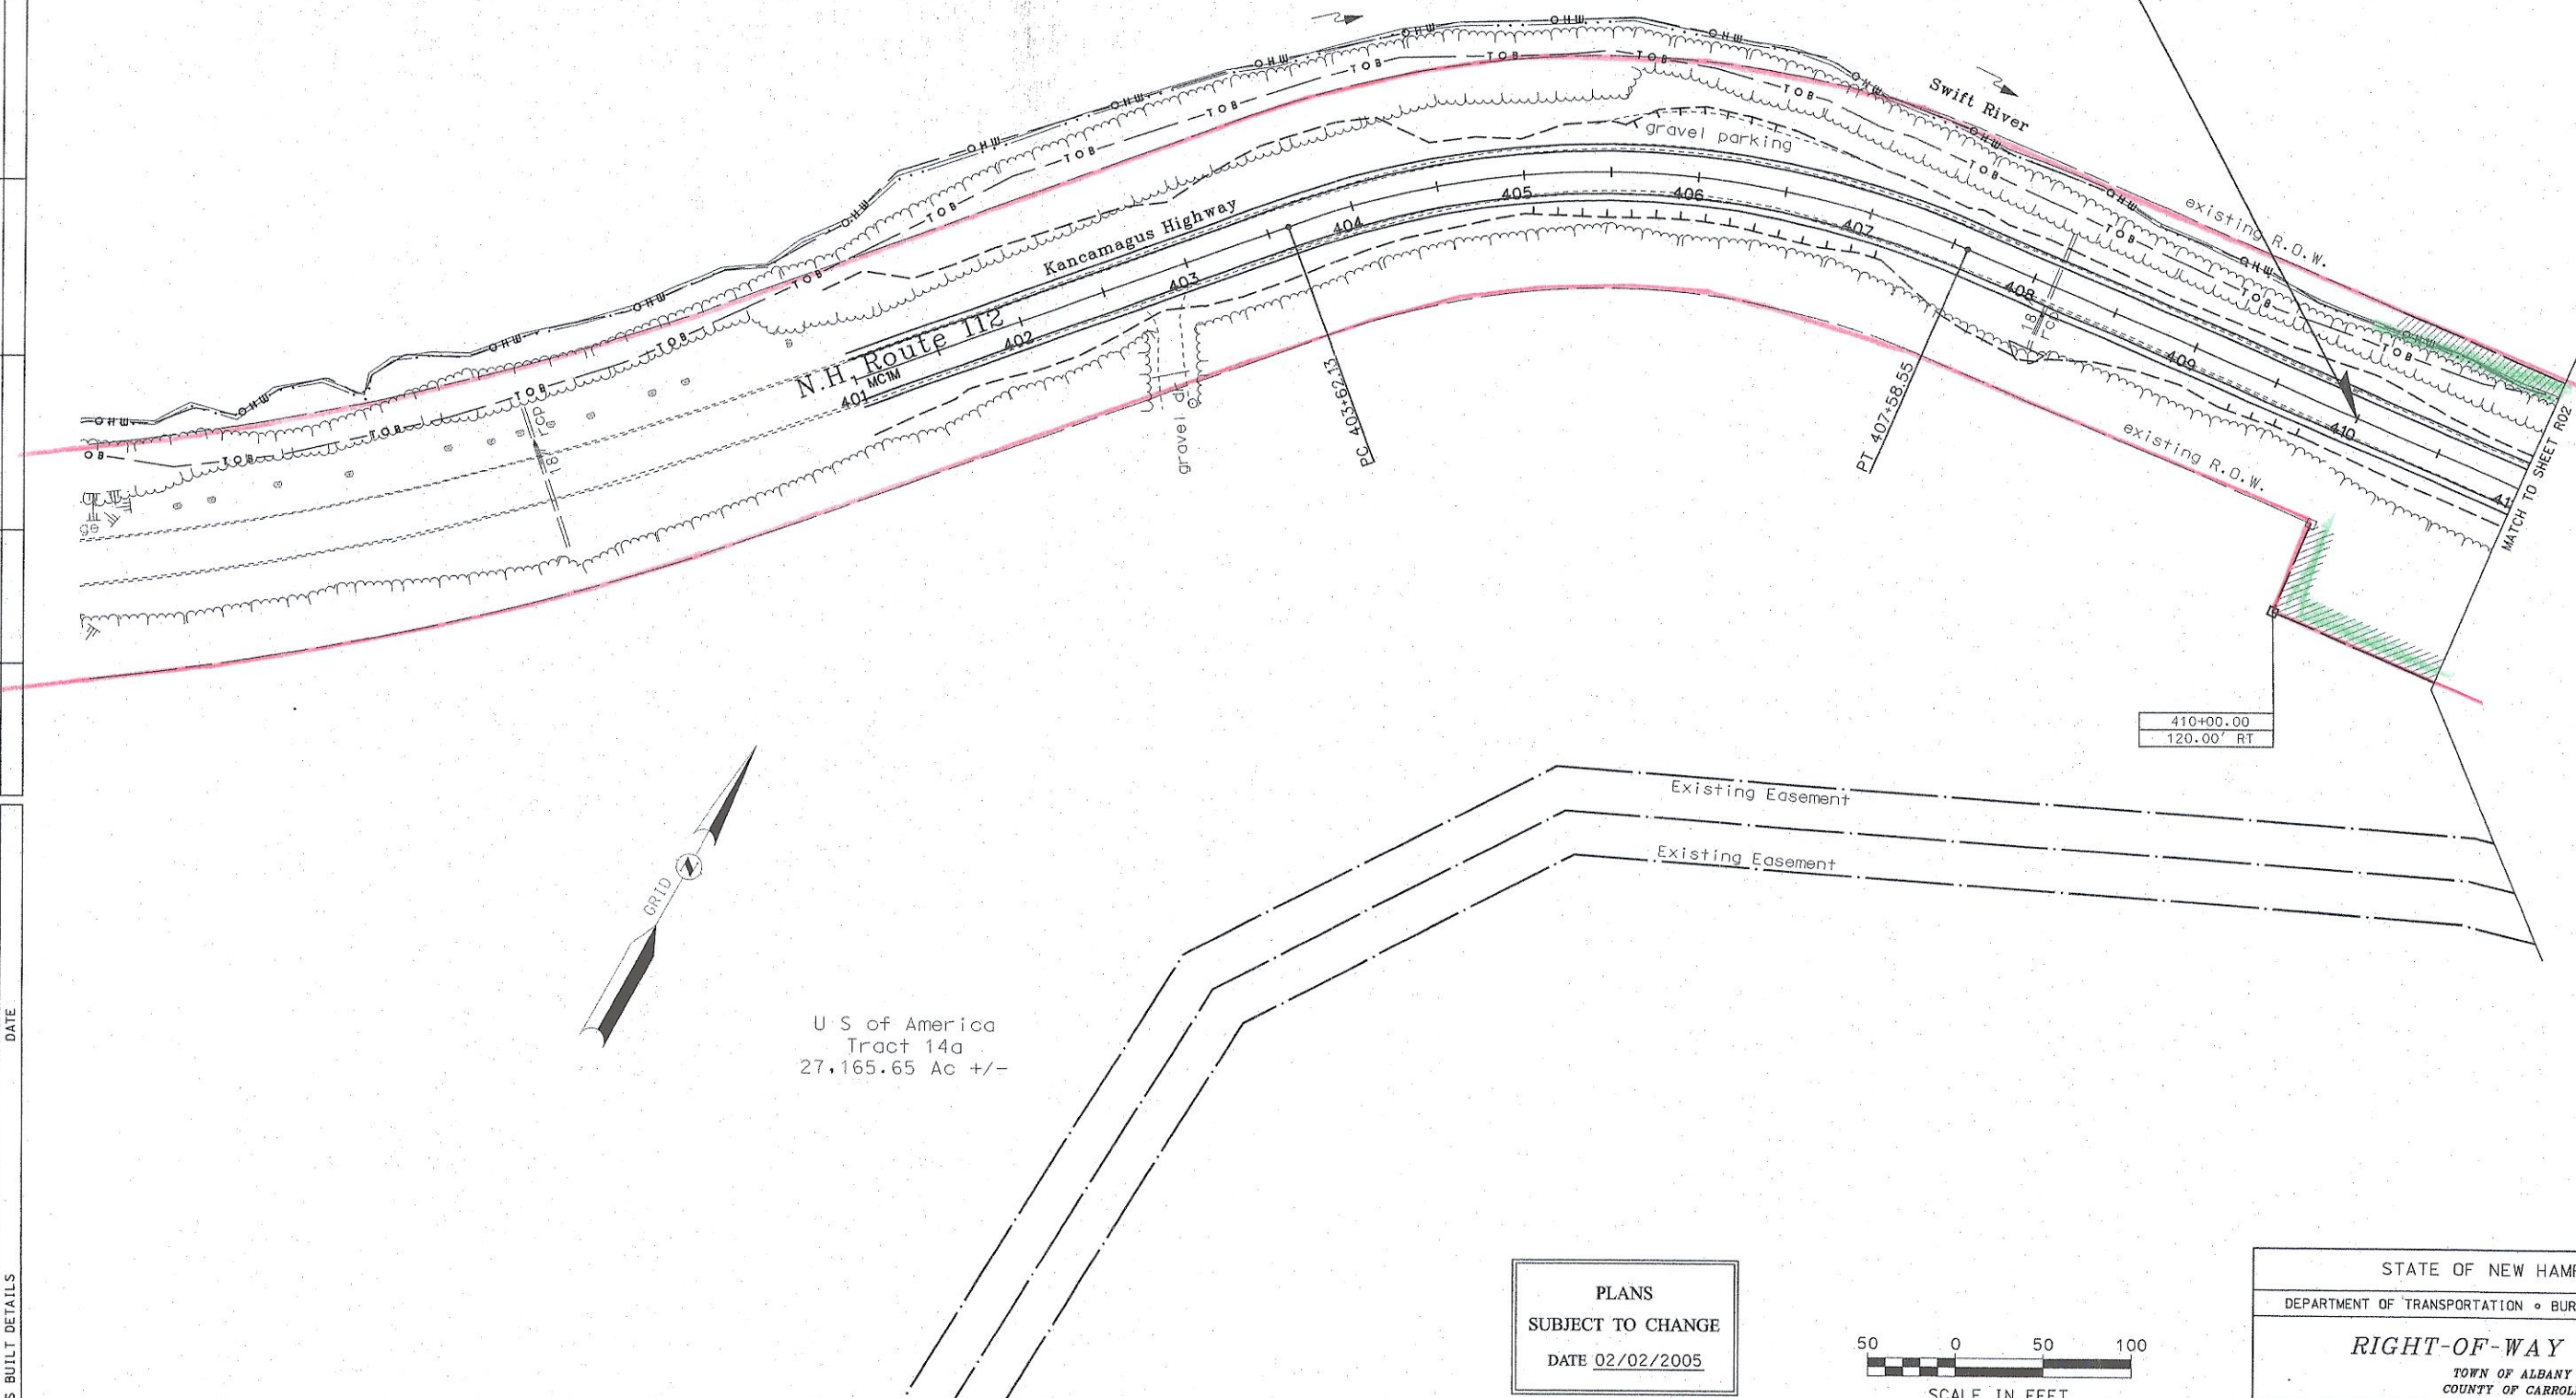

U S of America
Tract 14a
27,165.65 Ac +/-

PLANS
SUBJECT TO CHANGE
DATE 02/02/2005

50 0 50 100
SCALE IN FEET

STATE OF NEW HAMPSHIRE			
DEPARTMENT OF TRANSPORTATION • BUREAU OF RIGHT-OF-WAY			
RIGHT-OF-WAY PLANS			
TOWN OF ALBANY COUNTY OF CARROLL			
DGN	STATE PROJECT NO.	SHEET NO.	TOTAL SHEETS
13632BR01	13632B	4	8

REVISIONS AFTER PROPOSAL		STATION	DATE	NUMBER	DESCRIPTION
SDR PROCESSED	Plan Prep				
NEW DESIGN	Brian Cassel	DATE	Jan. 2005		
SHEET CHECKED	Tobey Reynolds	DATE	Jan. 2005		
AS BUILT DETAILS		DATE			

SDR PROCESSED Plan Prep	DATE	July 2002
	DATE	Jan 2005
	DATE	Jan 2005
	DATE	Jan 2005
NEW DESIGN	DATE	July 2002
	DATE	Jan 2005
	DATE	Jan 2005
	DATE	Jan 2005
SHEET CHECKED	DATE	July 2002
	DATE	Jan 2005
	DATE	Jan 2005
	DATE	Jan 2005
AS BUILT DETAILS	DATE	July 2002
	DATE	Jan 2005
	DATE	Jan 2005
	DATE	Jan 2005

DESCRIPTION

REVISIONS AFTER PROPOSAL

STATION


STATION

DATE

NUMBER


DATE

DATE

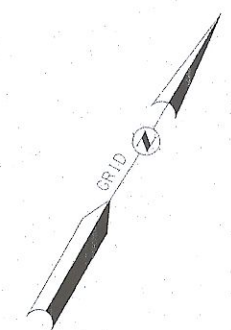


U S of America
Tract 14a
27,165.65 Ac +/-

PAR. No.	PROPERTY OWNER	TOTAL AREA OF PARCEL Ac.	TAKE Ac.	REMAINDER		PERMANENT TYPE	EASEMENT SF.	TEMPORARY DESCRIPTION	EXPIRES	CARROW POINTS OF		REV. No.
				LEFT Ac.	RIGHT Ac.					LT.	RT.	
TRACT 14a	US OF AMERICA	27,165.65				SEE SHEET 13632BR01						

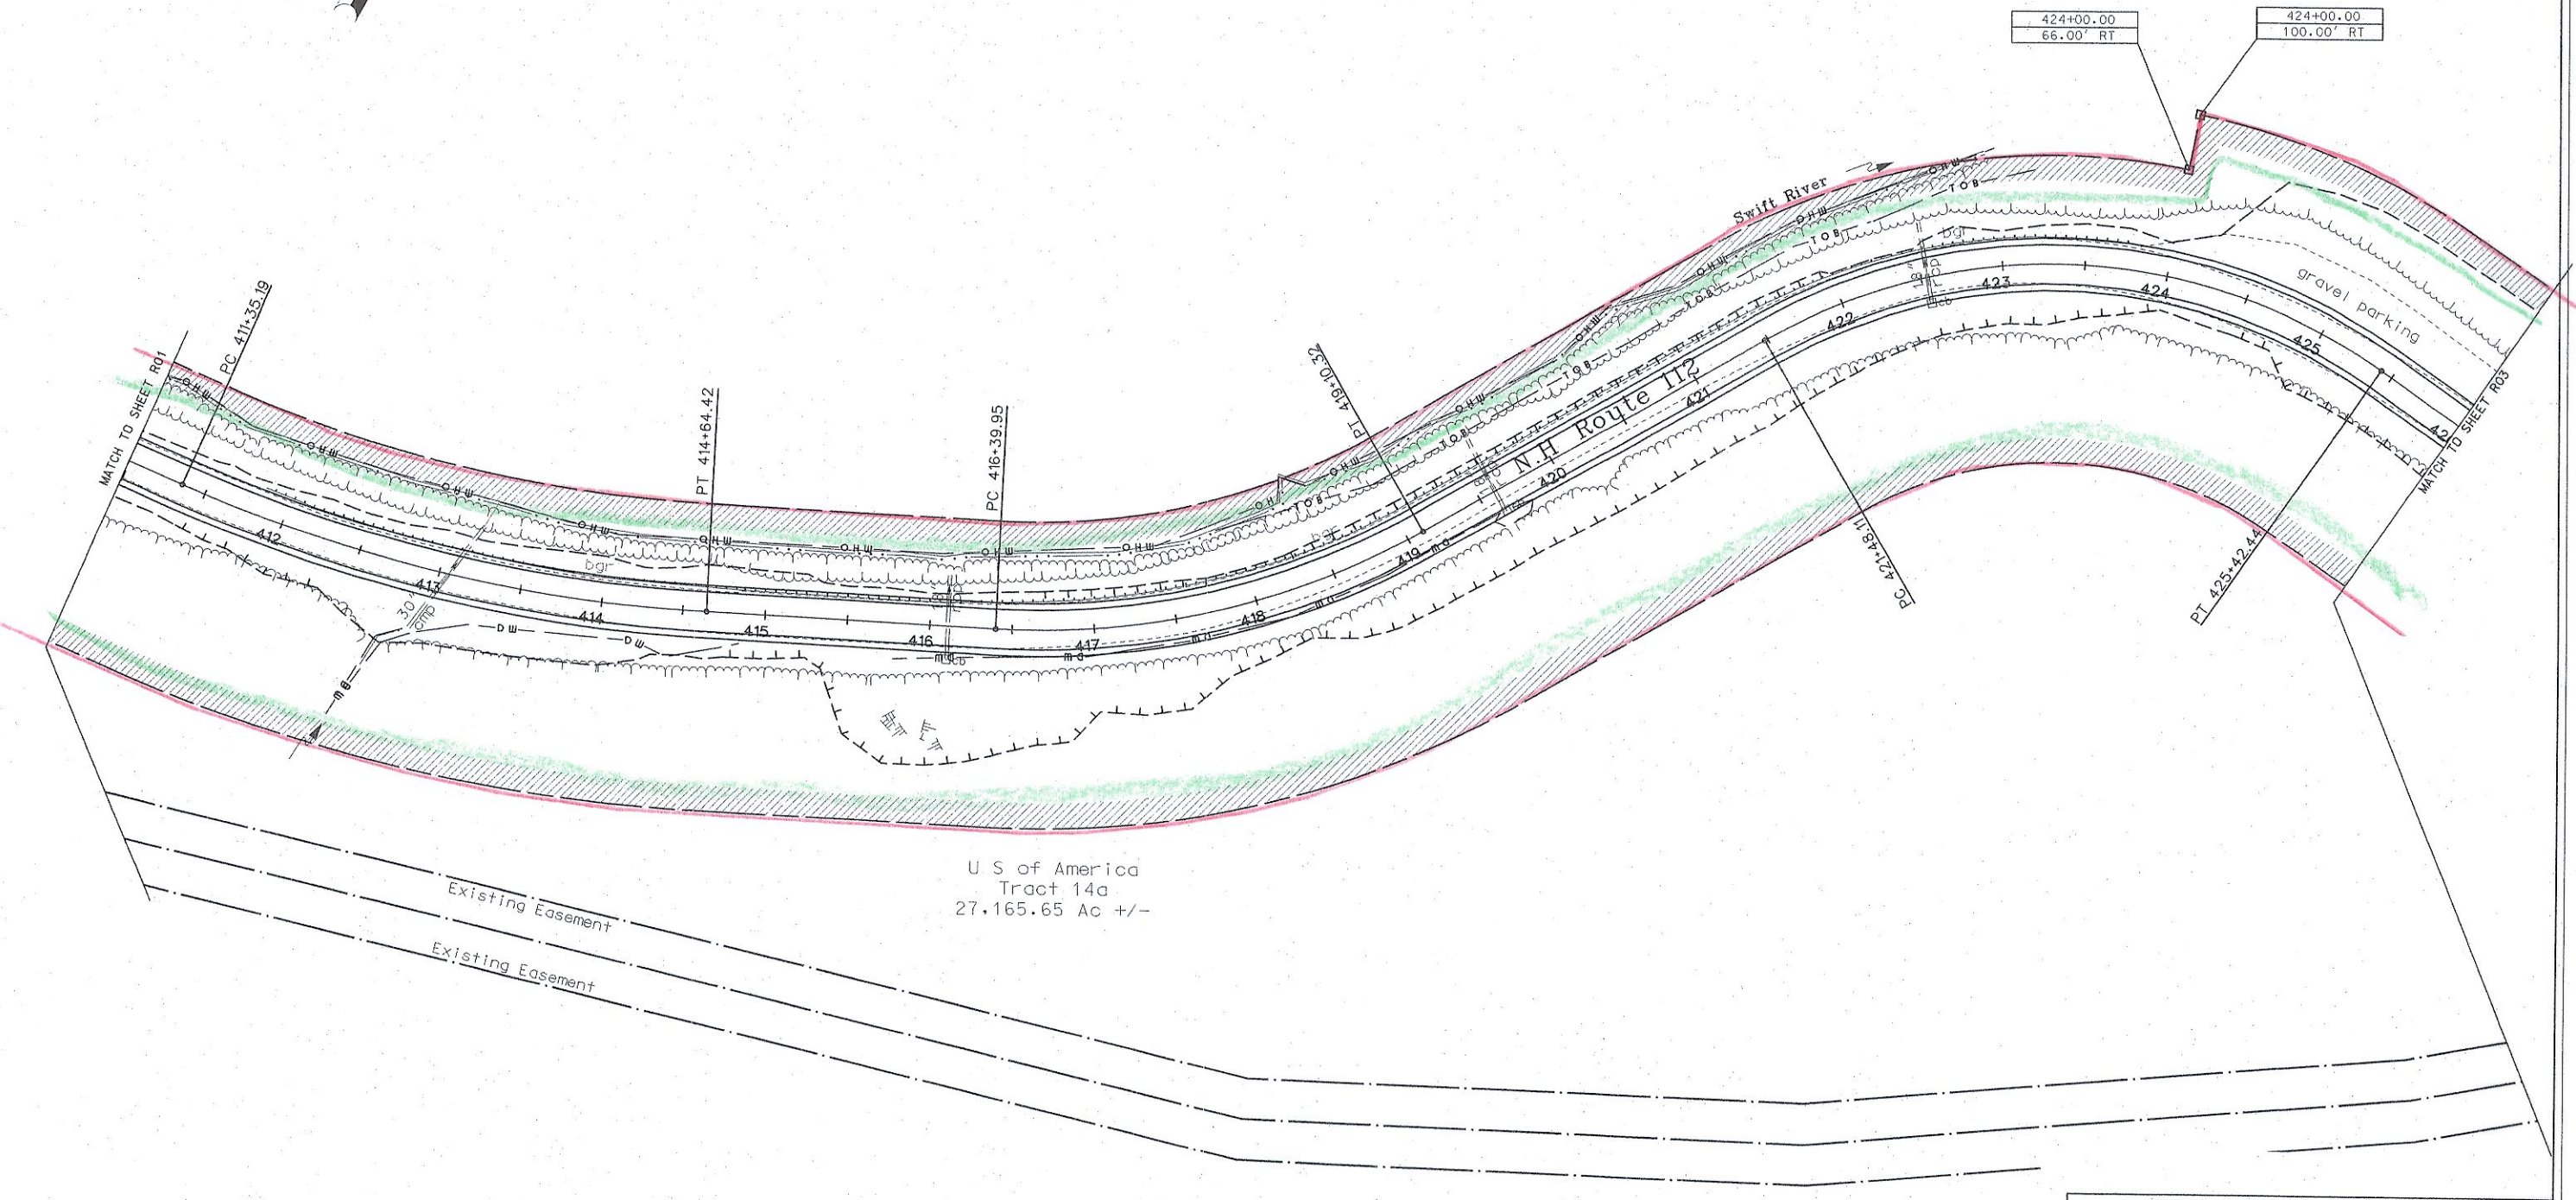


U S of America
Tract 14a
27,165.65 Ac +/-

PLANS
SUBJECT TO CHANGE
DATE 02/02/2005

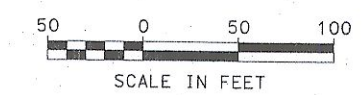


STATE OF NEW HAMPSHIRE			
DEPARTMENT OF TRANSPORTATION • BUREAU OF RIGHT-OF-WAY			
RIGHT-OF-WAY PLANS			
TOWN OF ALBANY COUNTY OF CARROLL			
DGN	STATE PROJECT NO.	SHEET NO.	TOTAL SHEETS
13632BR02	13632B	5	8

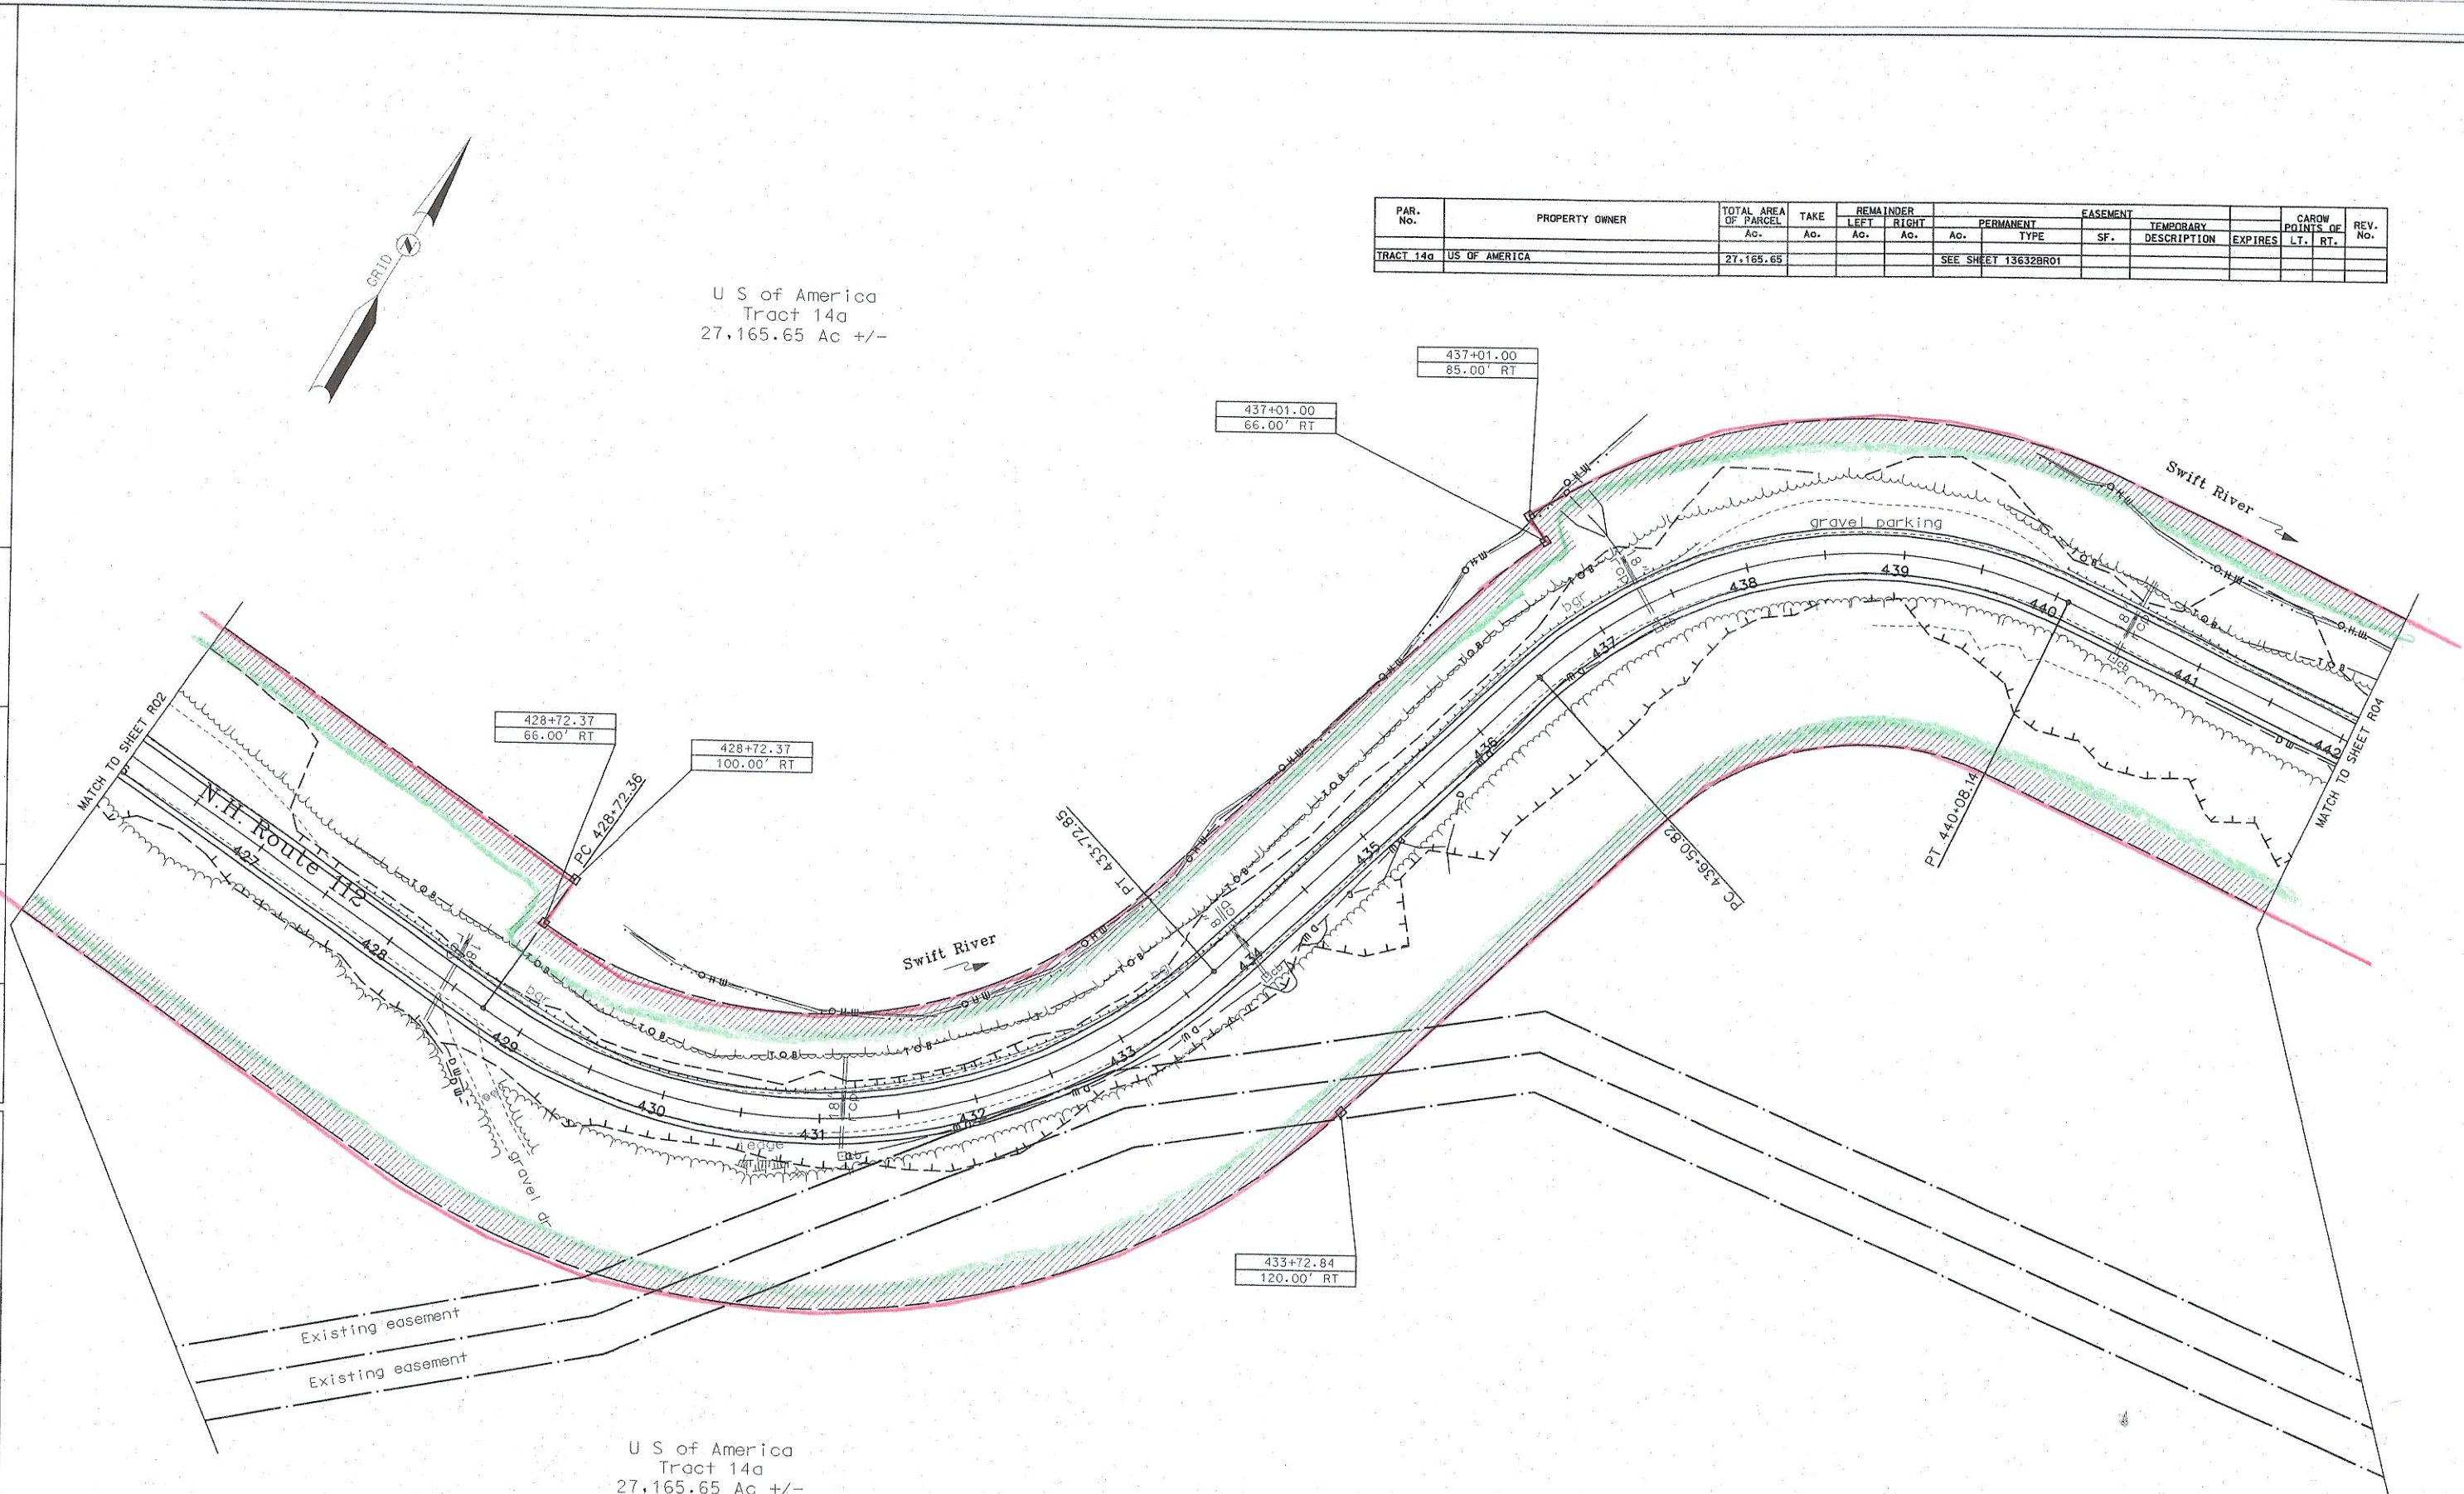[illegible]

PAR. No.	PROPERTY OWNER	TOTAL AREA OF PARCEL Ac.	TAKE Ac.	REMAINDER		EASEMENT				CAROW POINTS OF LT. RT.	REV. No.	
				LEFT Ac.	RIGHT Ac.	PERMANENT		SF.	TEMPORARY DESCRIPTION			EXPIRES
						Ac.	TYPE					
TRACT 14a	US OF AMERICA	27.165.65				SEE SHEET 136328R01						

PLANS
SUBJECT TO CHANGE
DATE 02/02/2005

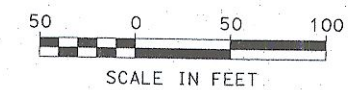

STATE OF NEW HAMPSHIRE			
DEPARTMENT OF TRANSPORTATION • BUREAU OF RIGHT-OF-WAY			
<i>RIGHT-OF-WAY PLANS</i> TOWN OF ALBANY COUNTY OF CARROLL			
DGN	STATE PROJECT NO.	SHEET NO.	TOTAL SHEETS
13632BR03	13632B	6	8

